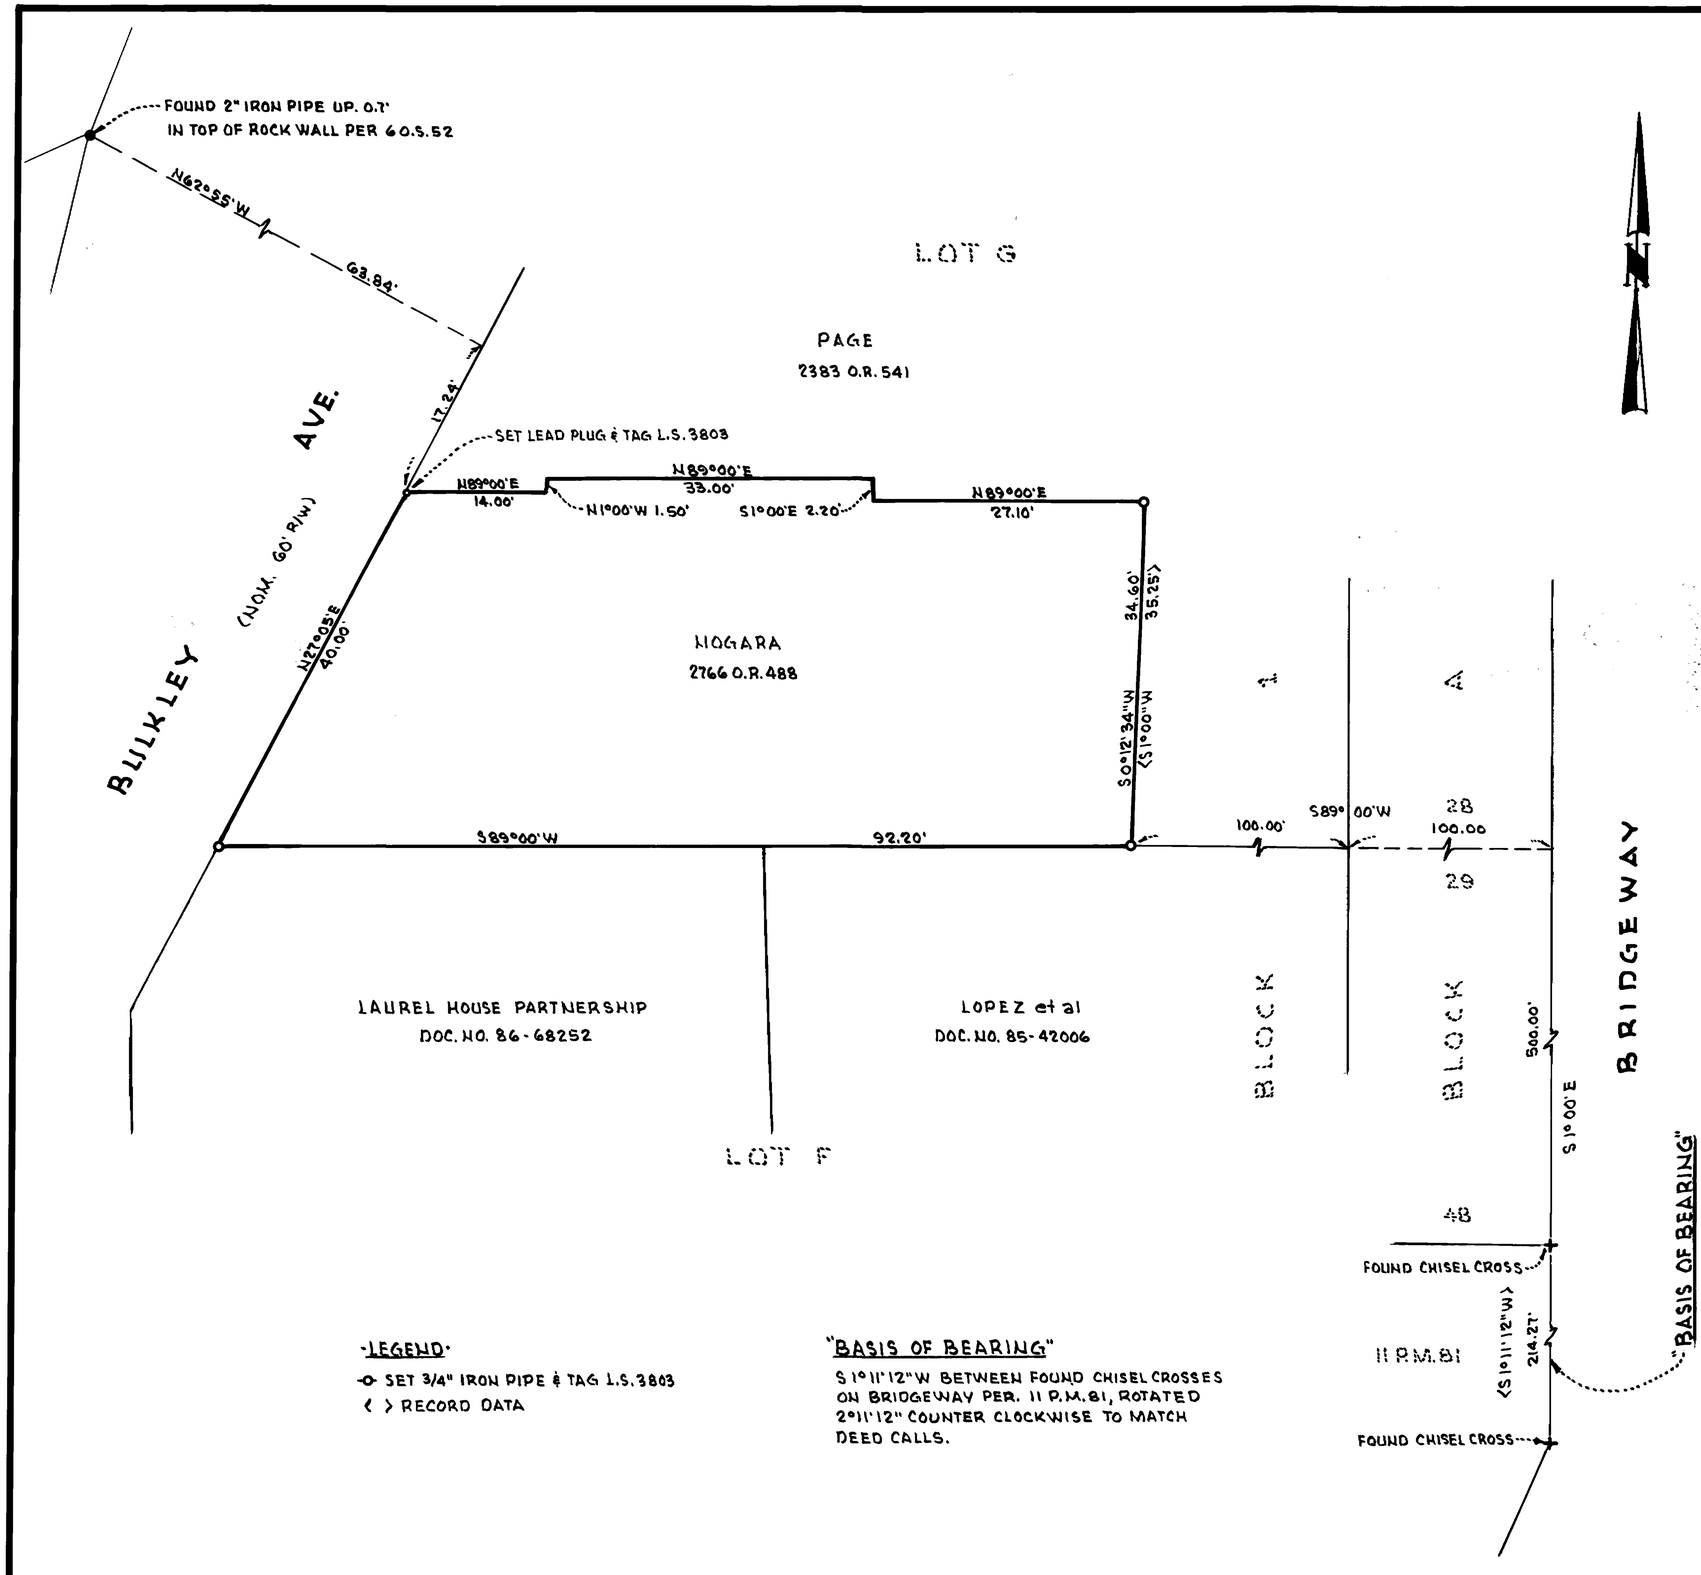

·LEGEND·

-o- SET 3/4" IRON PIPE & TAG L.S. 3803

< > RECORD DATA

"BASIS OF BEARING"

S 1°11'12"W BETWEEN FOUND CHISEL CROSSES ON BRIDGEWAY PER. 11 R.M. 81, ROTATED 2°11'12" COUNTER CLOCKWISE TO MATCH DEED CALLS.

SURVEYOR'S STATEMENT

THIS MAP CORRECTLY REPRESENTS A SURVEY MADE BY ME OR UNDER MY DIRECTION IN CONFORMANCE WITH THE REQUIREMENTS OF THE LAND SURVEYOR'S ACT AT THE REQUEST OF R. NOGARA.

Dale G. Waag

DALE G. WAAG ~~L.S. 3803~~

LICENSED LAND SURVEYOR · DALE GLENN WAAG · EXP. ~~6-30-88~~ · No. 3803 · STATE OF CALIFORNIA

COUNTY SURVEYOR'S STATEMENT

THIS MAP HAS BEEN EXAMINED IN ACCORDANCE WITH SECTION 8766 OF THE LAND SURVEYOR'S ACT.

THIS 10th DAY OF MARCH 1988.

M. MARJD-SARJADI
COUNTY SURVEYOR

Robert B. Beaumont
DEPUTY Ex. 3-31-88

REGISTERED PROFESSIONAL ENGINEER · ROBERT DARRELL BEAUMONT · C 30212 · CIVIL · STATE OF CALIFORNIA

RECORDER'S STATEMENT

FILED THIS 14th DAY OF MARCH 1988.
AT 11:30 AM IN BOOK 24 OF SURVEYS AT PAGE 26 AT THE REQUET OF SCHWARTZ-WAAG ASSOC. INC. AND DEPT. OF PUBLIC WORKS.

SERIAL NO. 88-13405 FEE: $6.00

James G. Dal Bon
COUNTY RECORDER.

Jorrie Dávalos
DEPUTY

RECORD OF SURVEY

LANDS OF

R.&S. NOGARA 2766 O.R. 488

BEING

PORTION LOT G - BLOCK 1

SUB. OF BLK'S. 1, 2, A & B SEC. MAP C

SAUSALITO LAND & FERRY CO. RACK 1 - PULL 3

SAUSALITO - —— - MARIN CO. - —— - CALIFORNIA

SCHWARTZ·WAAG ASSOCIATES, INC.

NOVATO - ——— - CALIFORNIA

SCALE 1" = 10' JANUARY 1988

AP. 65-171-20 NO. 5761 1 OF 1

Can 6380